





← Transportable Radio Package

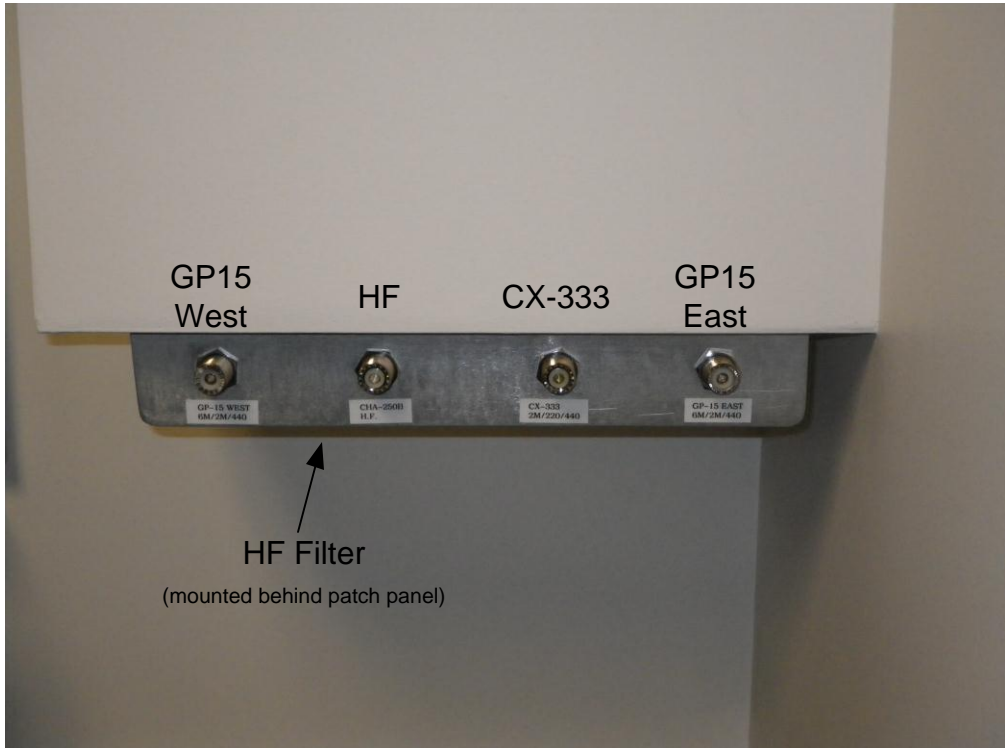

Antenna Patch Panel

Rivcomm, Inc.	1330 Dodson Way Riverside, CA 92507 951.328.0211	Date 05-26-2011	Made CR	Kaiser Permanente Sherman Way Lab A.E.O.C.
----------------------	--	--------------------	------------	---

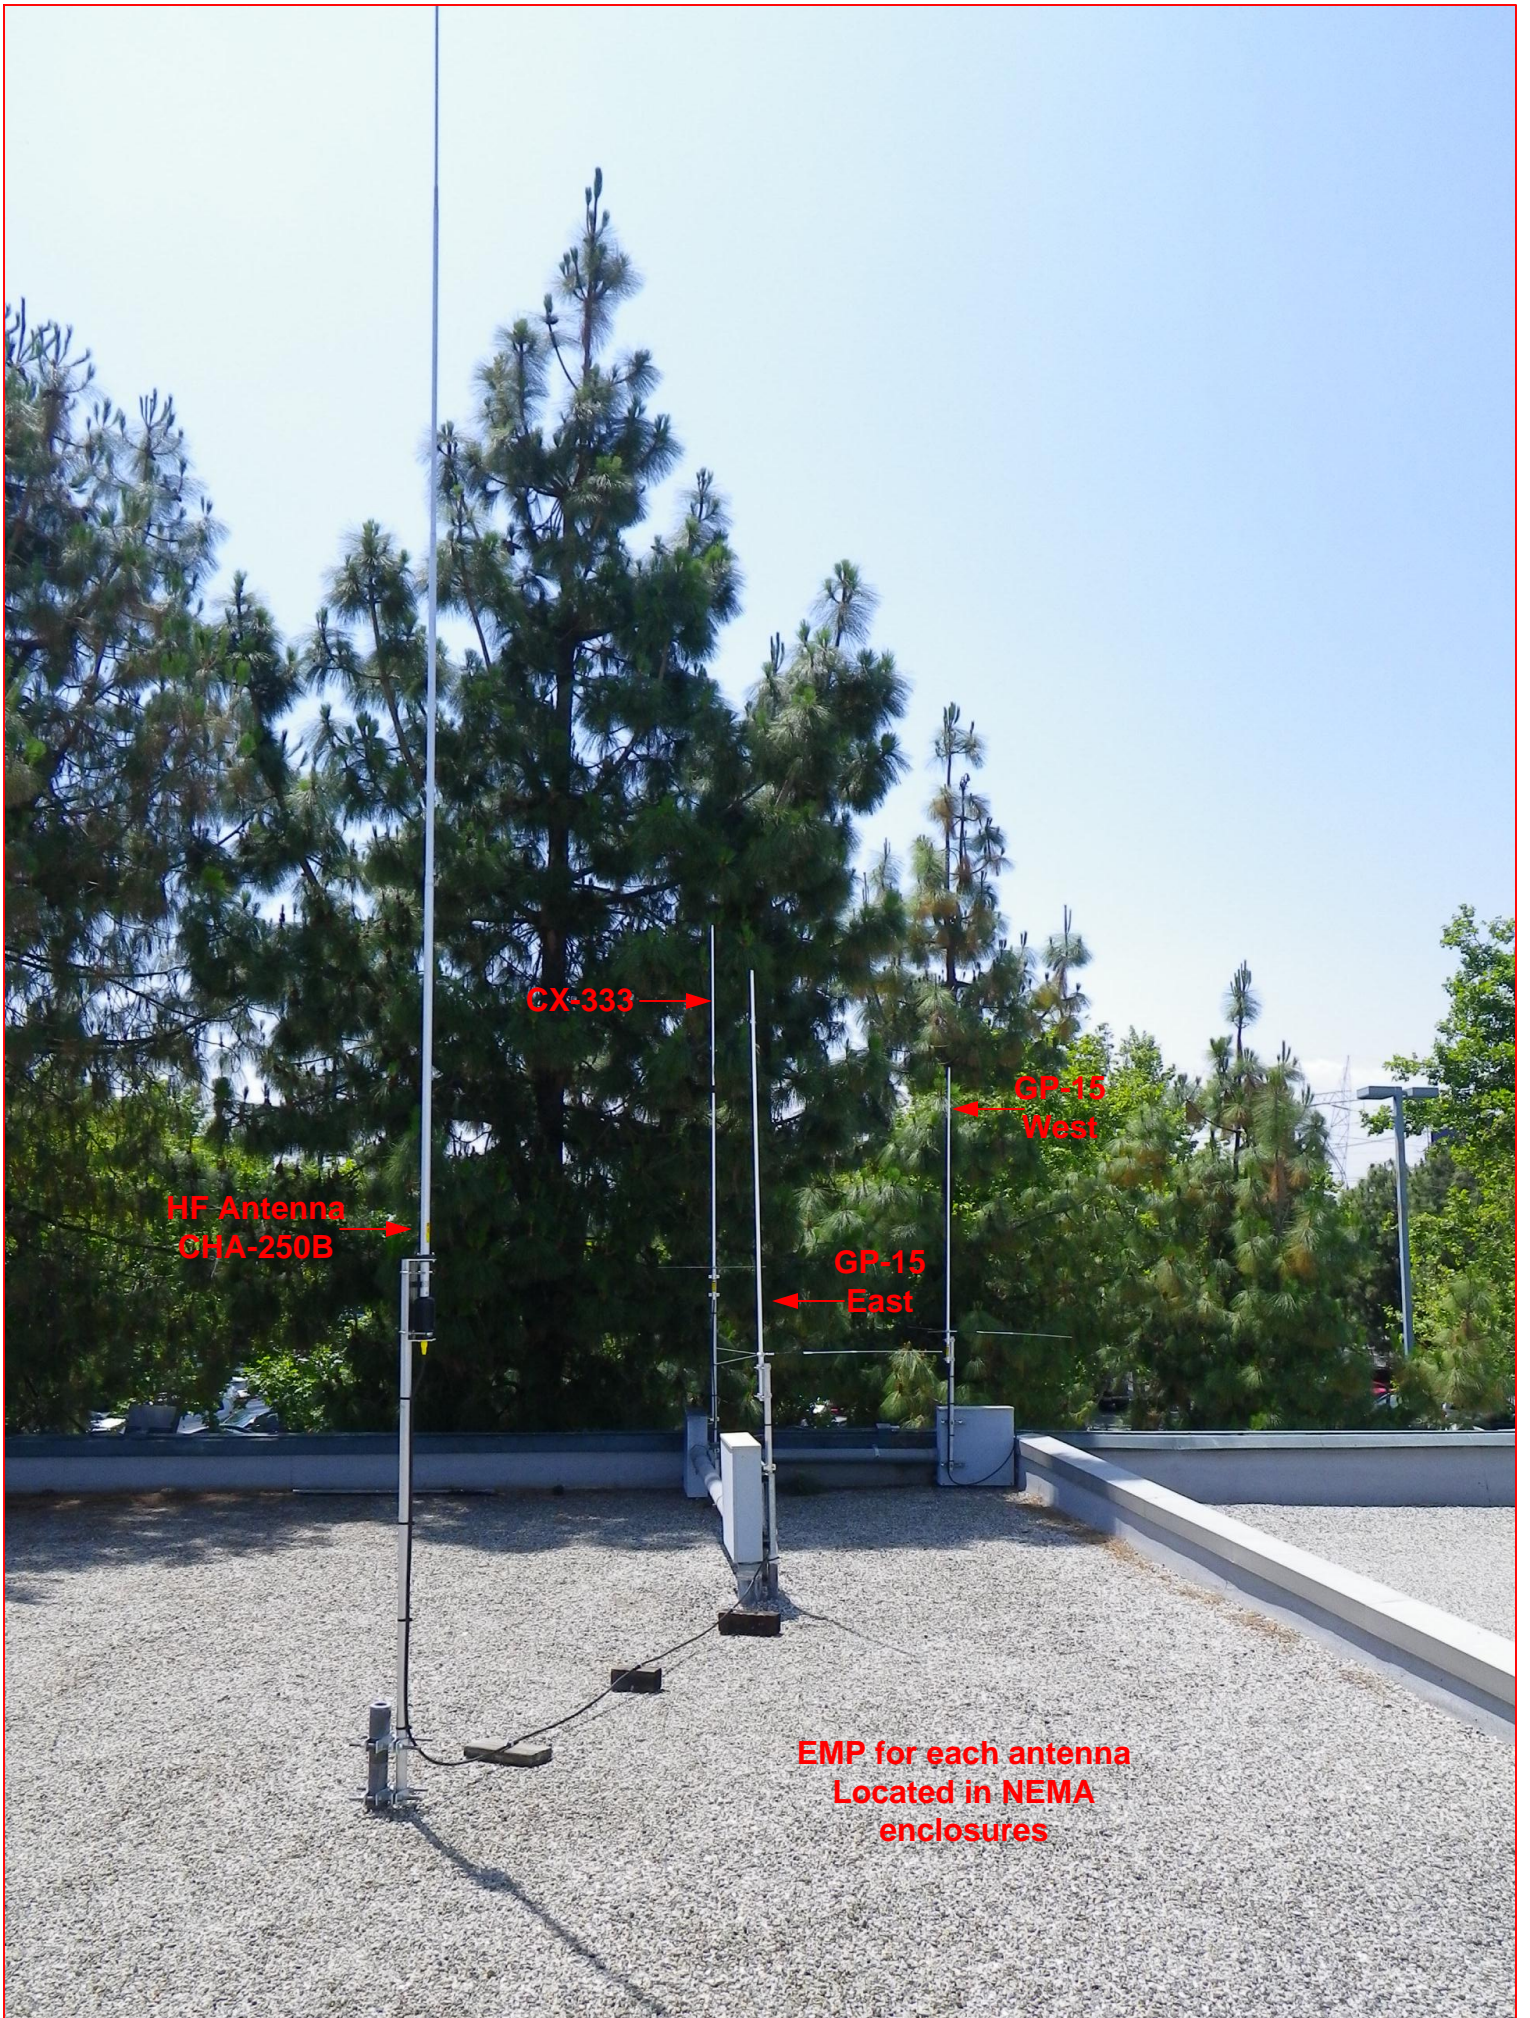

HF Antenna
CHA-250B

CX-333

GP-15
East

GP-15
West

EMP for each antenna
Located in NEMA
enclosures